


RIVER OAKS ELEMENTARY SCHOOL ASR WELL SITE REQUEST

LOCATION MAP - N.T.S.



SEWER CONSTRUCTION PERMIT: 36,456-WW
WATER CONSTRUCTION PERMIT: 27,543 WS
DATE OF INSTALLATION: MARCH-MAY 2011

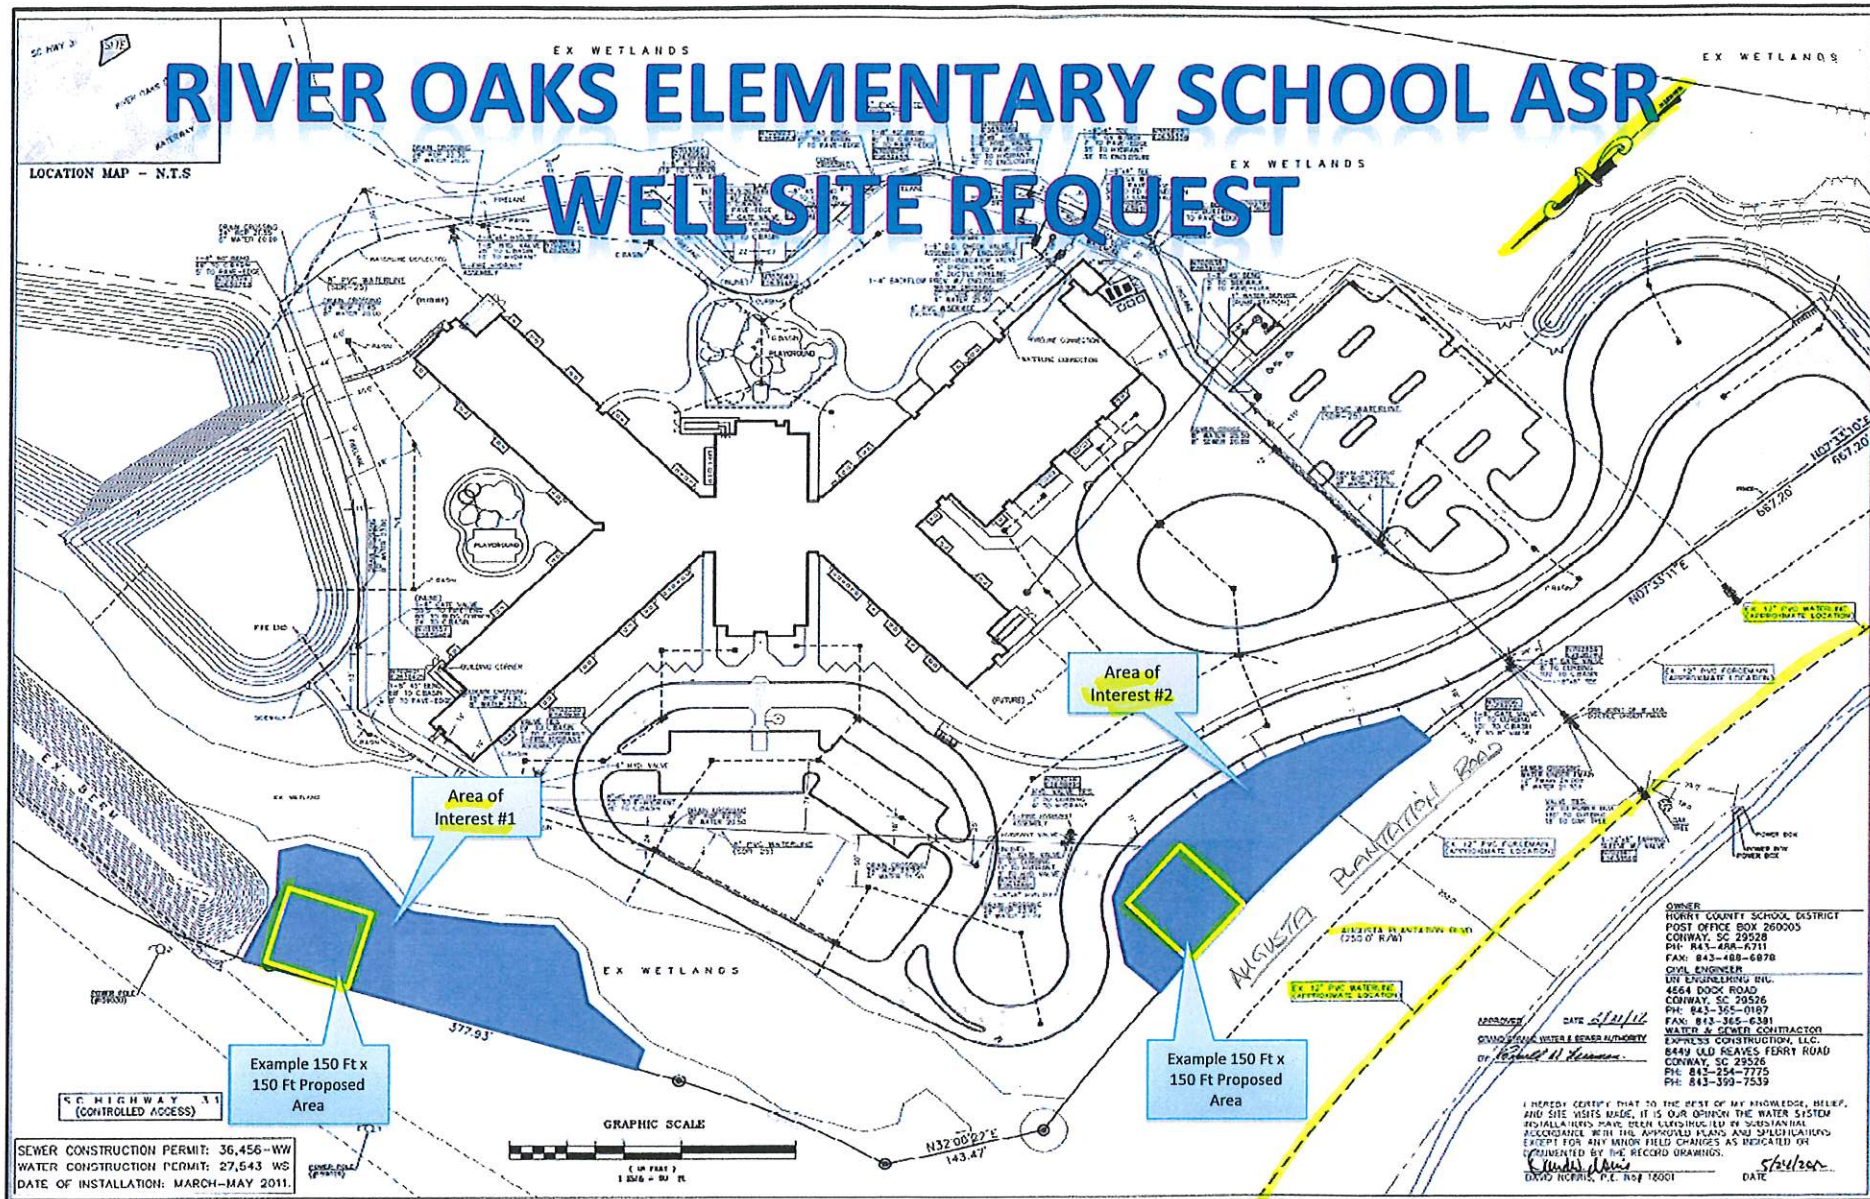

32-226-003/3 W

DN ENGINEERING, INC.
4664 DOCK ROAD
CONWAY, SC 29526
PHONE: 843-365-0187
FAX: 843-365-0381
EMAIL: NORRIS@SCCOST.NET

RECORD DRAWINGS-WATER SYSTEM
RIVER OAKS ELEMENTARY SCHOOL
CONWAY, SC 29526
FOR: Horry County School District

SCALE: 1" = 50 FT
DATE: 5/14/11
DRAWN BY: B. BISHOP
CHECKED BY: B. BISHOP
DESIGNED BY: B. BISHOP
APPROVED BY: B. BISHOP
1. PER CIVIL REVIEW

OWNER:
HORRY COUNTY SCHOOL DISTRICT
POST OFFICE BOX 260005
CONWAY, SC 29526
PH: 843-484-4711
FAX: 843-488-6878
CIVIL ENGINEER:
DN ENGINEERING, INC.
4664 DOCK ROAD
CONWAY, SC 29526
PH: 843-365-0187
FAX: 843-365-0381
WATER & SEWER CONTRACTOR:
EXPRESS CONSTRUCTION, LLC
8449 OLD REAVES FERRY ROAD
CONWAY, SC 29526
PH: 843-254-7775
FAX: 843-359-7539

SHEET NUMBER
W 1
3 of 3



